AS BUILT

Inspected by: Darren Schoenwald

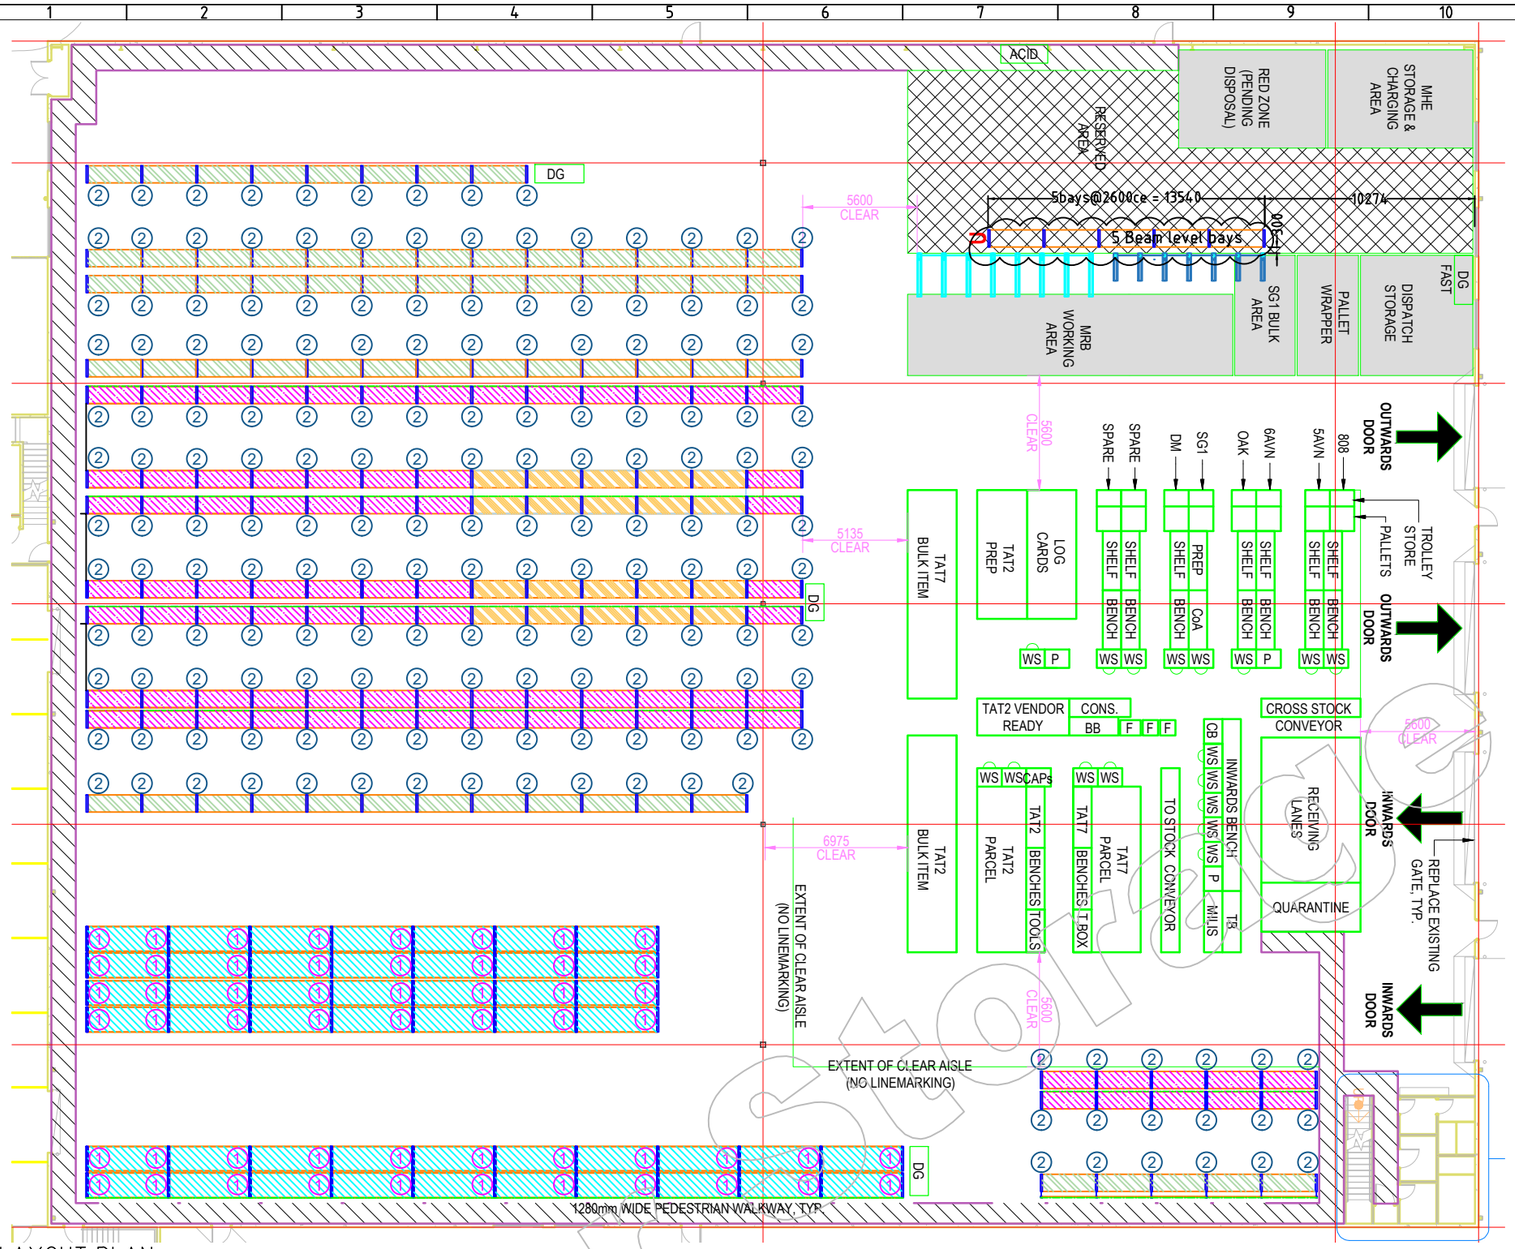

LAYOUT PLAN

SCALE 1 : 300

Racking details refer to drawing 210356-101F.

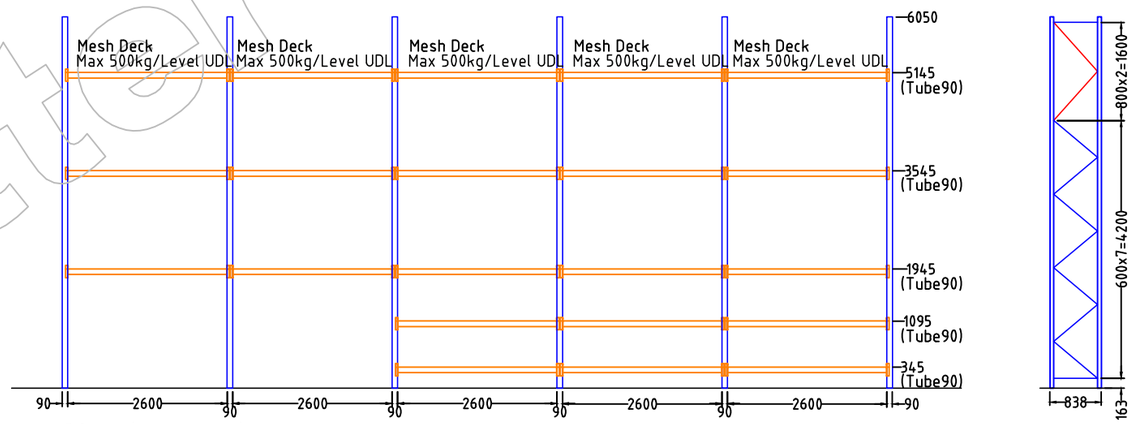

ROW U (Add on row)

All Beam levels are with Mesh Decks supplied by client.

FRONT VIEW

SCALE 1 : 100

Rev	Description	By	Date	Chk
C	AS BUILT	VL	29/10/20	KT
B	RELOCATE THE ROW	VL	22/10/20	KT
A	ADD ONE ROW	VL	20/10/20	KT

TITLE. Lanskey Construction - Airbus
MacArthur Ave Central, Pinkenba
AS BUILT Drawing

Better Storage Systems

Better Storage Systems

BNE: 2810 Ipswich Rd, Darra QLD4076
SYD: Level 5, Nexus Building, 4 Columbia Court, Baulkham Hills NSW2153
T : 1300 571 277 W : betterstorage.com.au

THIS DRAWING AND INFORMATION IT CONTAINS IS CONFIDENTIAL AND MUST NOT BE REPRODUCED, COPIED OR USED FOR ANY PURPOSE WITHOUT THE WRITTEN PERMISSION OF BETTER STORAGE SYSTEMS

Drawn	VL	Date	20/10/20
Checked	KT	Scale	AS SHOWN
Dwg No.	210356-103C	Rev No.	
		Sht	A3

Better Storage Systems